


2nd Floor - Suite 230 Existing As-Built Conditions 10,696 RSF

485

485 Half Day Road Buffallo Grove, IL



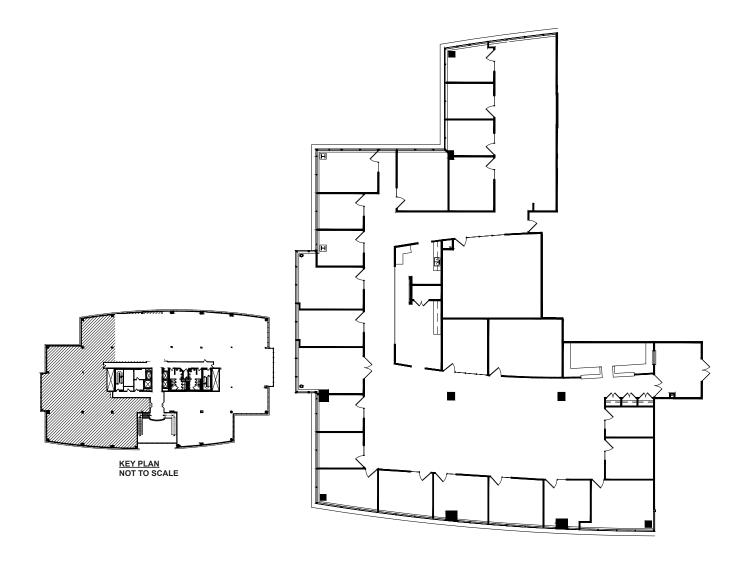

For further information, please contact our exclusive agents:

John Clark Rob Lundin 773.957.1410 773.957.1411 jclark@ngkf.com rlundin@ngkf.com